




2
C2
HANDICAP SIGN
SCALE: 1 1/2" = 1'-0"

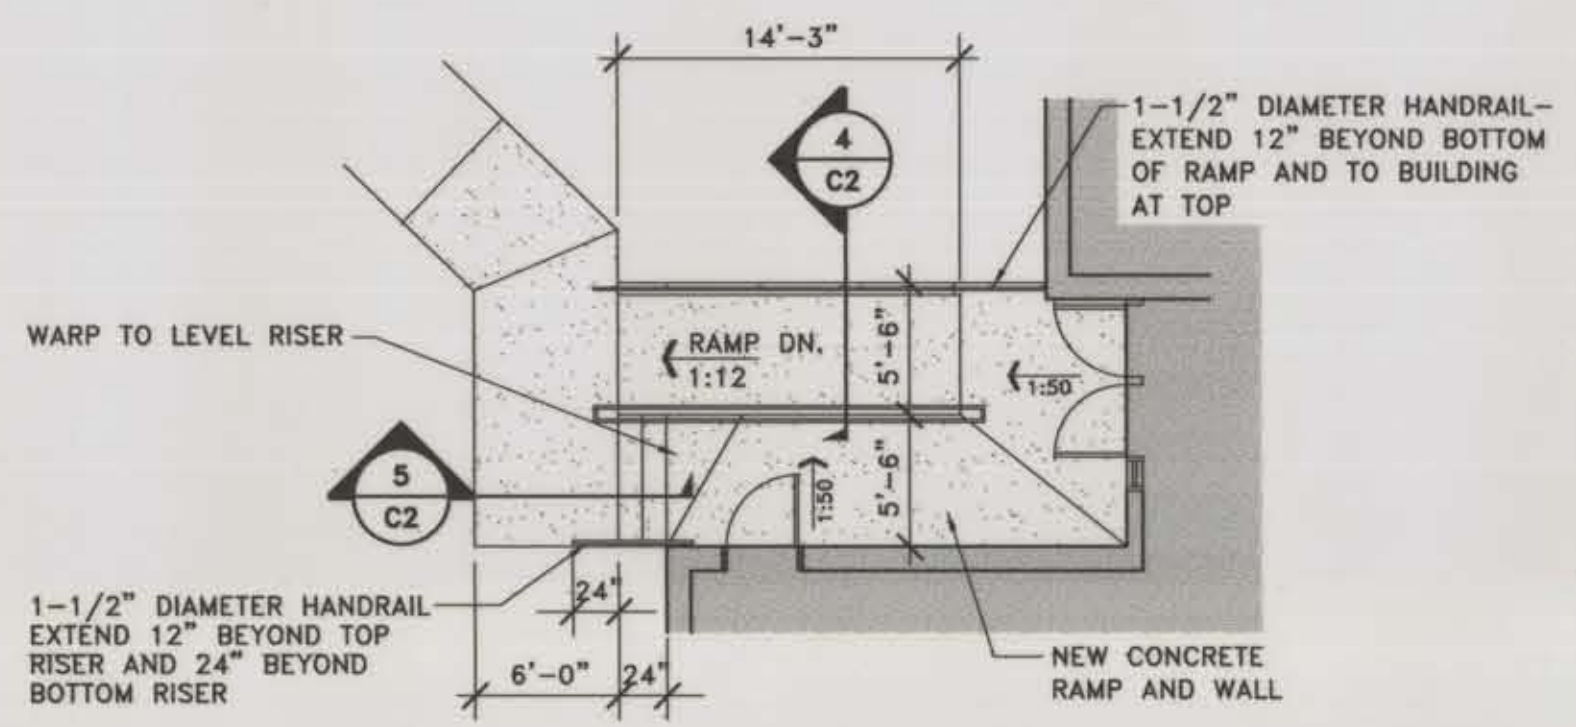


3
C2
RAMP PLAN
SCALE: 1/8" = 1'-0"

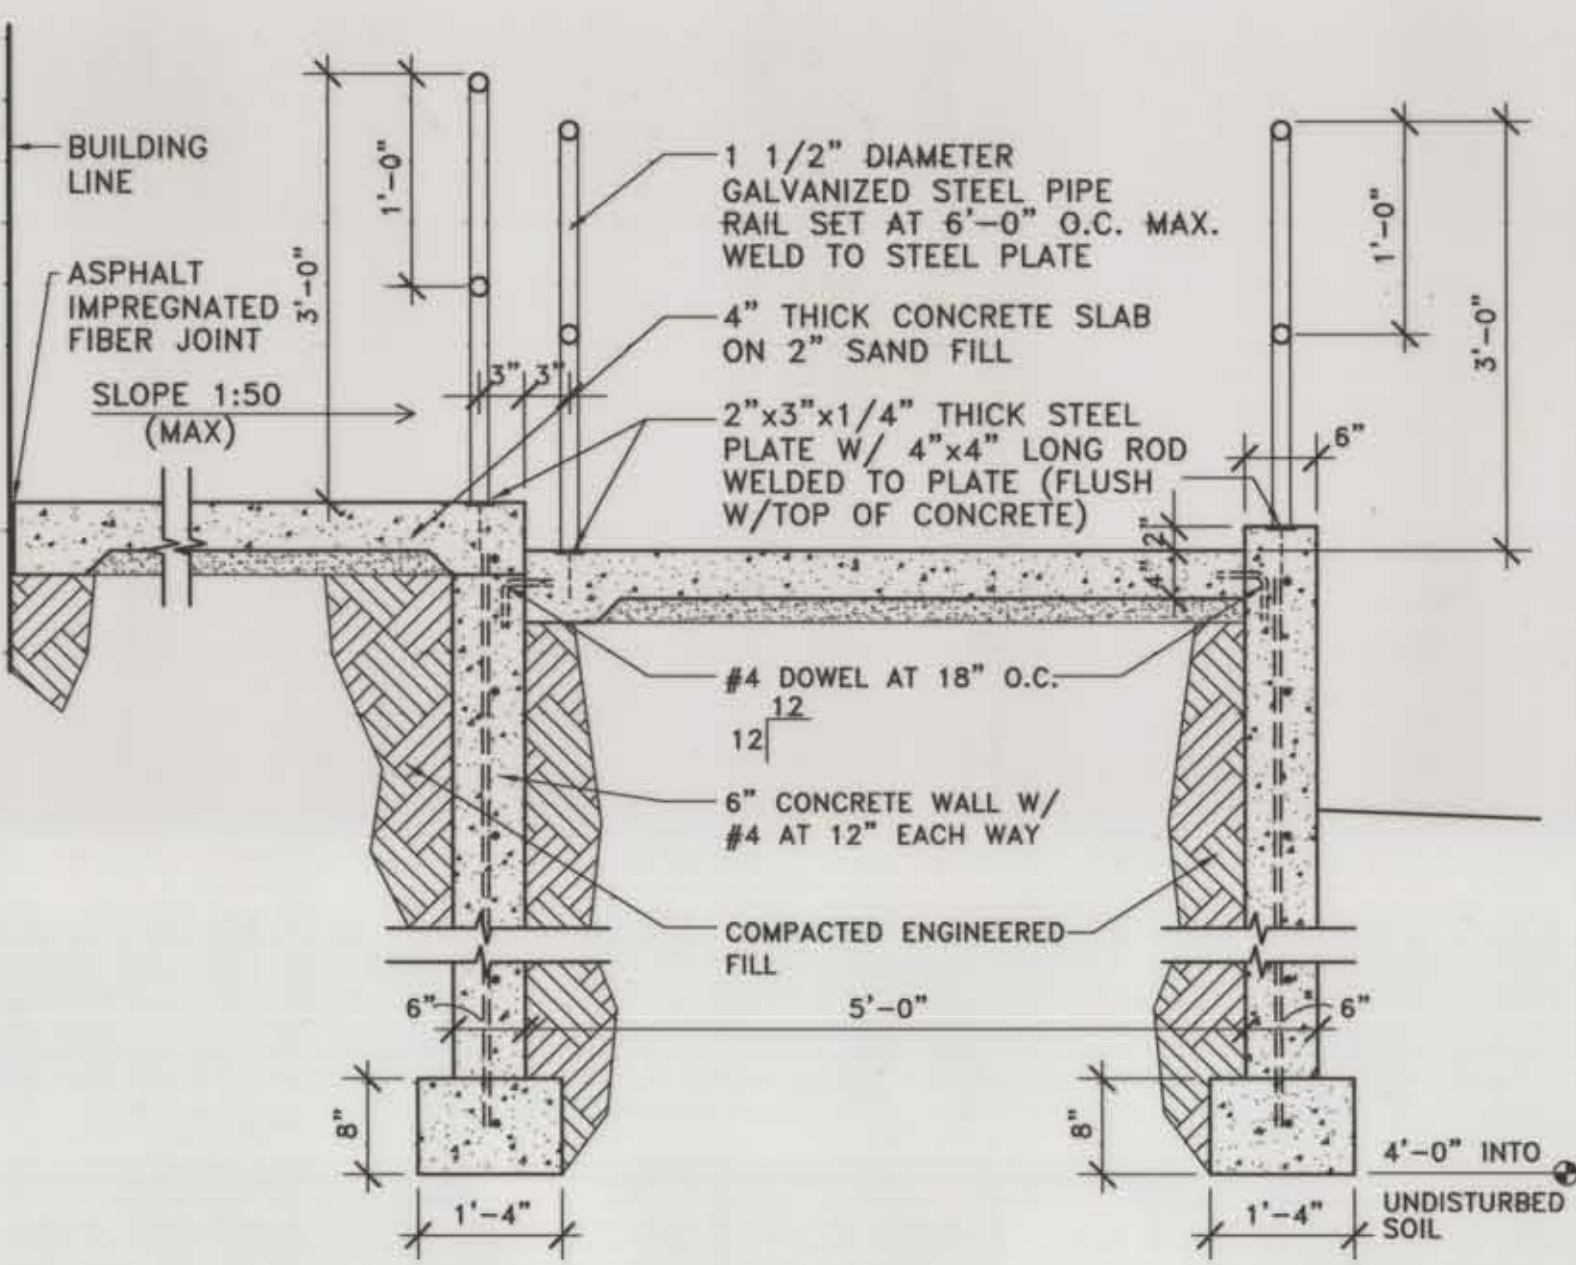


4
C2
SECTION AT RAMP AND LANDING
SCALE: 3/4" = 1'-0"

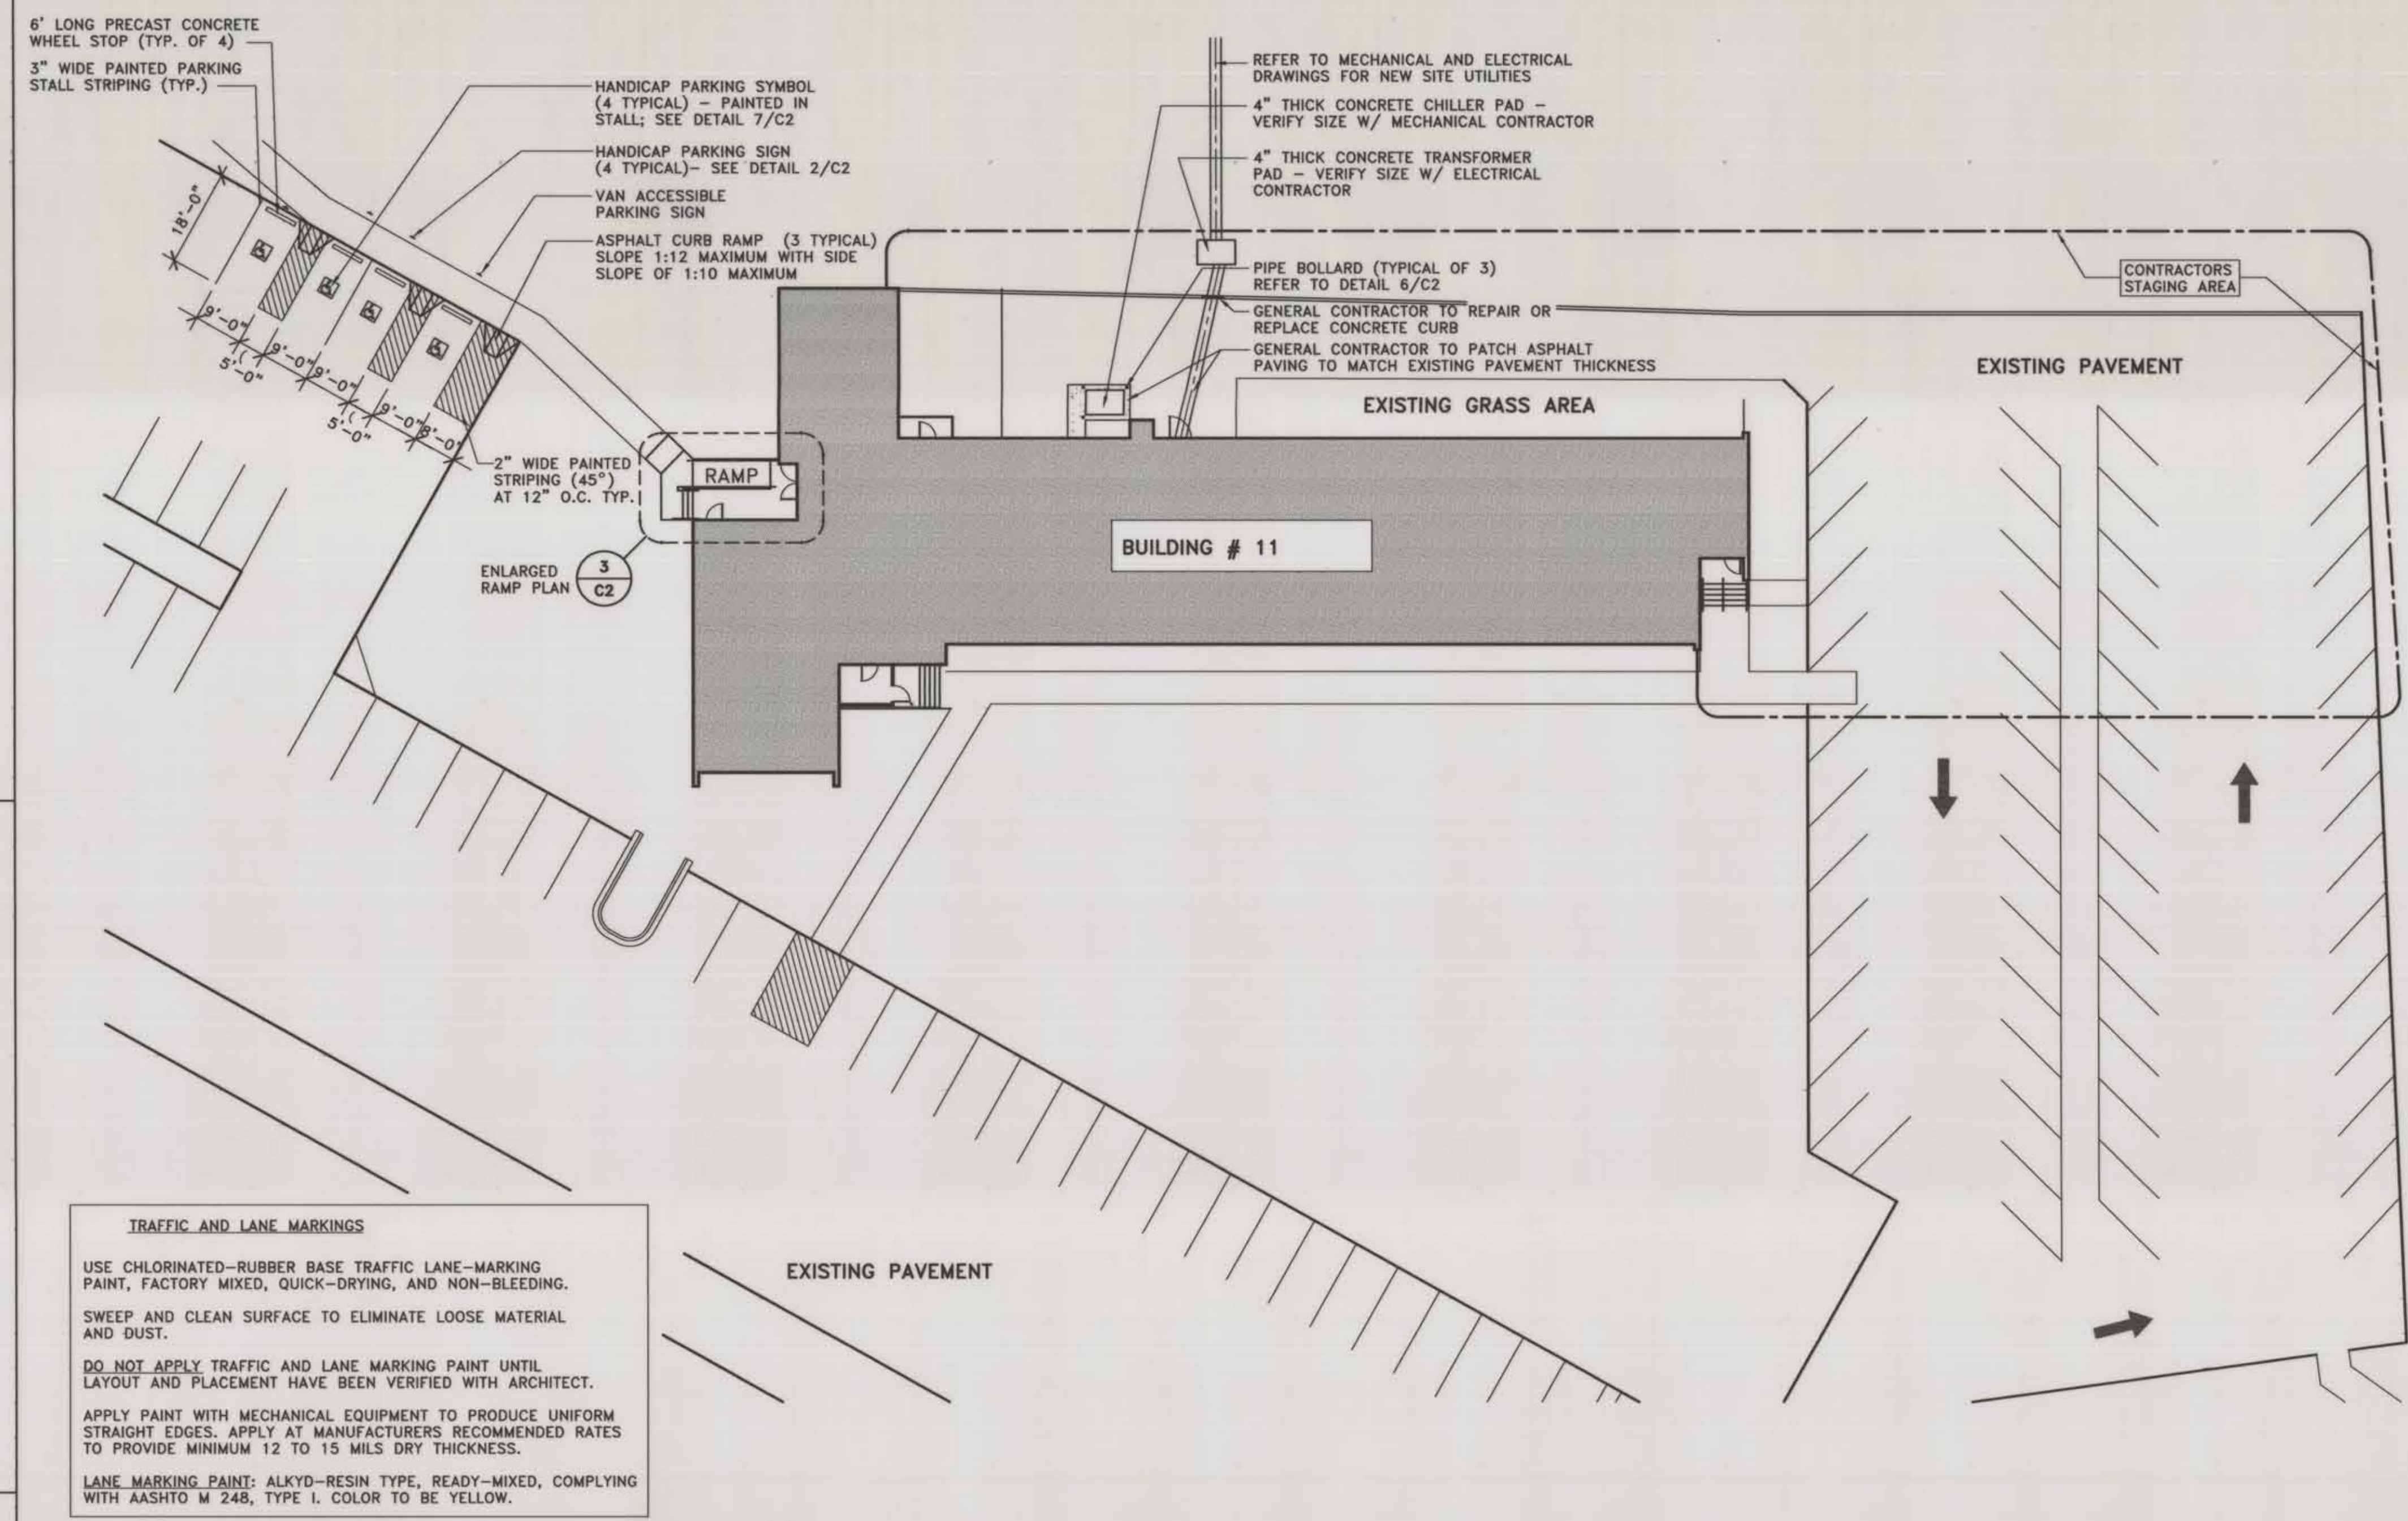


1
C2
SITE PLAN
SCALE: 1" = 20'-0"

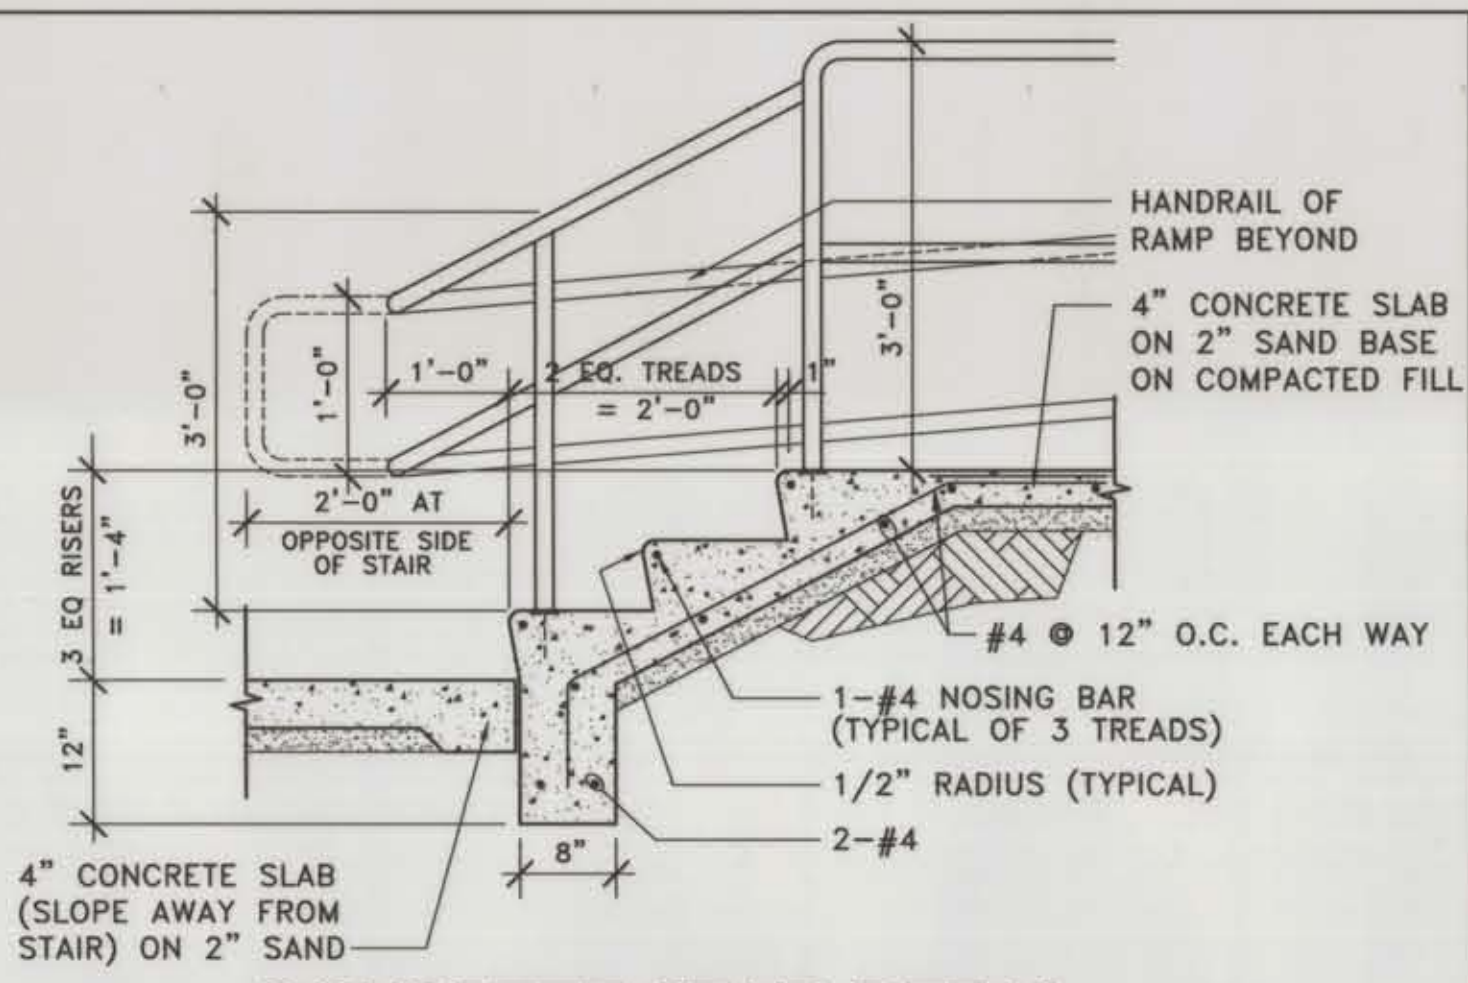

5
C2
CONCRETE STAIR DETAIL
SCALE: 3/4" = 1'-0"

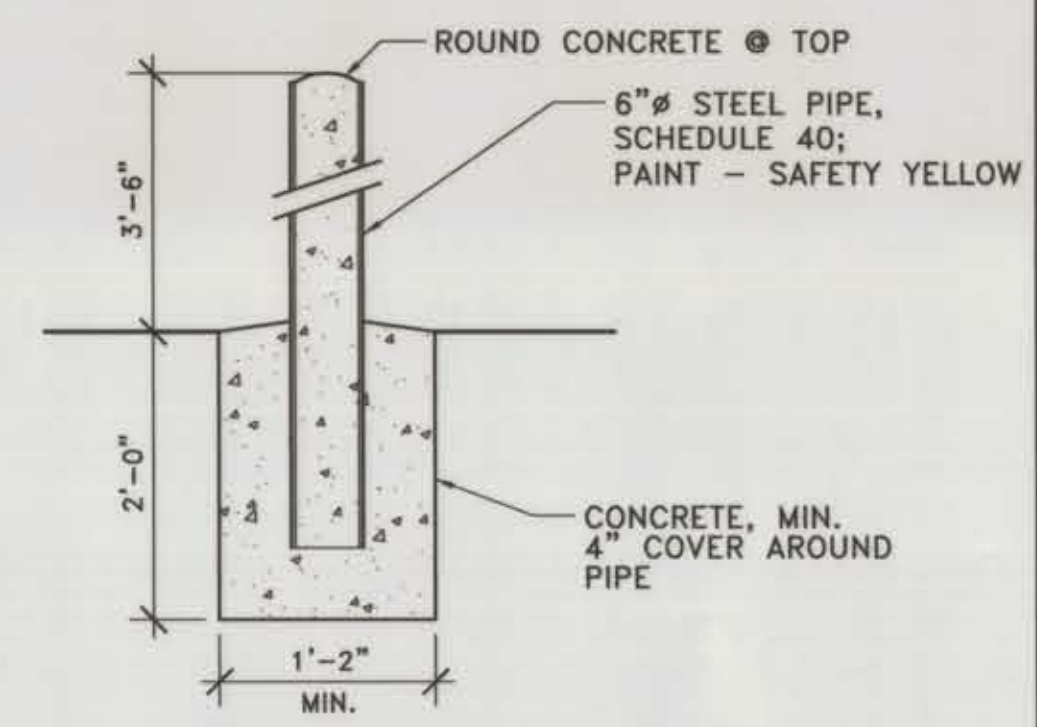

6
C2
BOLLARD
SCALE: 3/4" = 1'-0"

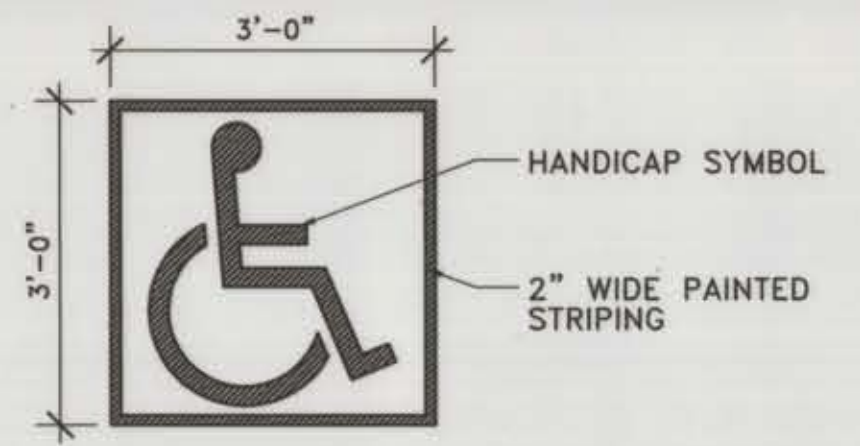

7
C2
H/C PARKING SYMBOL
NO SCALE

AS BUILT DRAWING

644 Grand Avenue
Billings, Montana 59101
406-249-6383

JGA
ARCHITECTS
ENGINEERS
PLANNERS

RENOVATION OF APSARUKE HALL
MSU-BILLINGS
BILLINGS, MONTANA

JOB NO. 9504
DRAWN BY MJH/JEO
CHECKED TS
DATE 11-3-95
REVISED 12-4-96

1" = 20'-0"

C2