



JOB NO.	9504
DRAWN BY	BMB/DJ
CHECKED	WML/DJ
DATE	12-1-95
REVISED	12-10-96

9504M4

M4

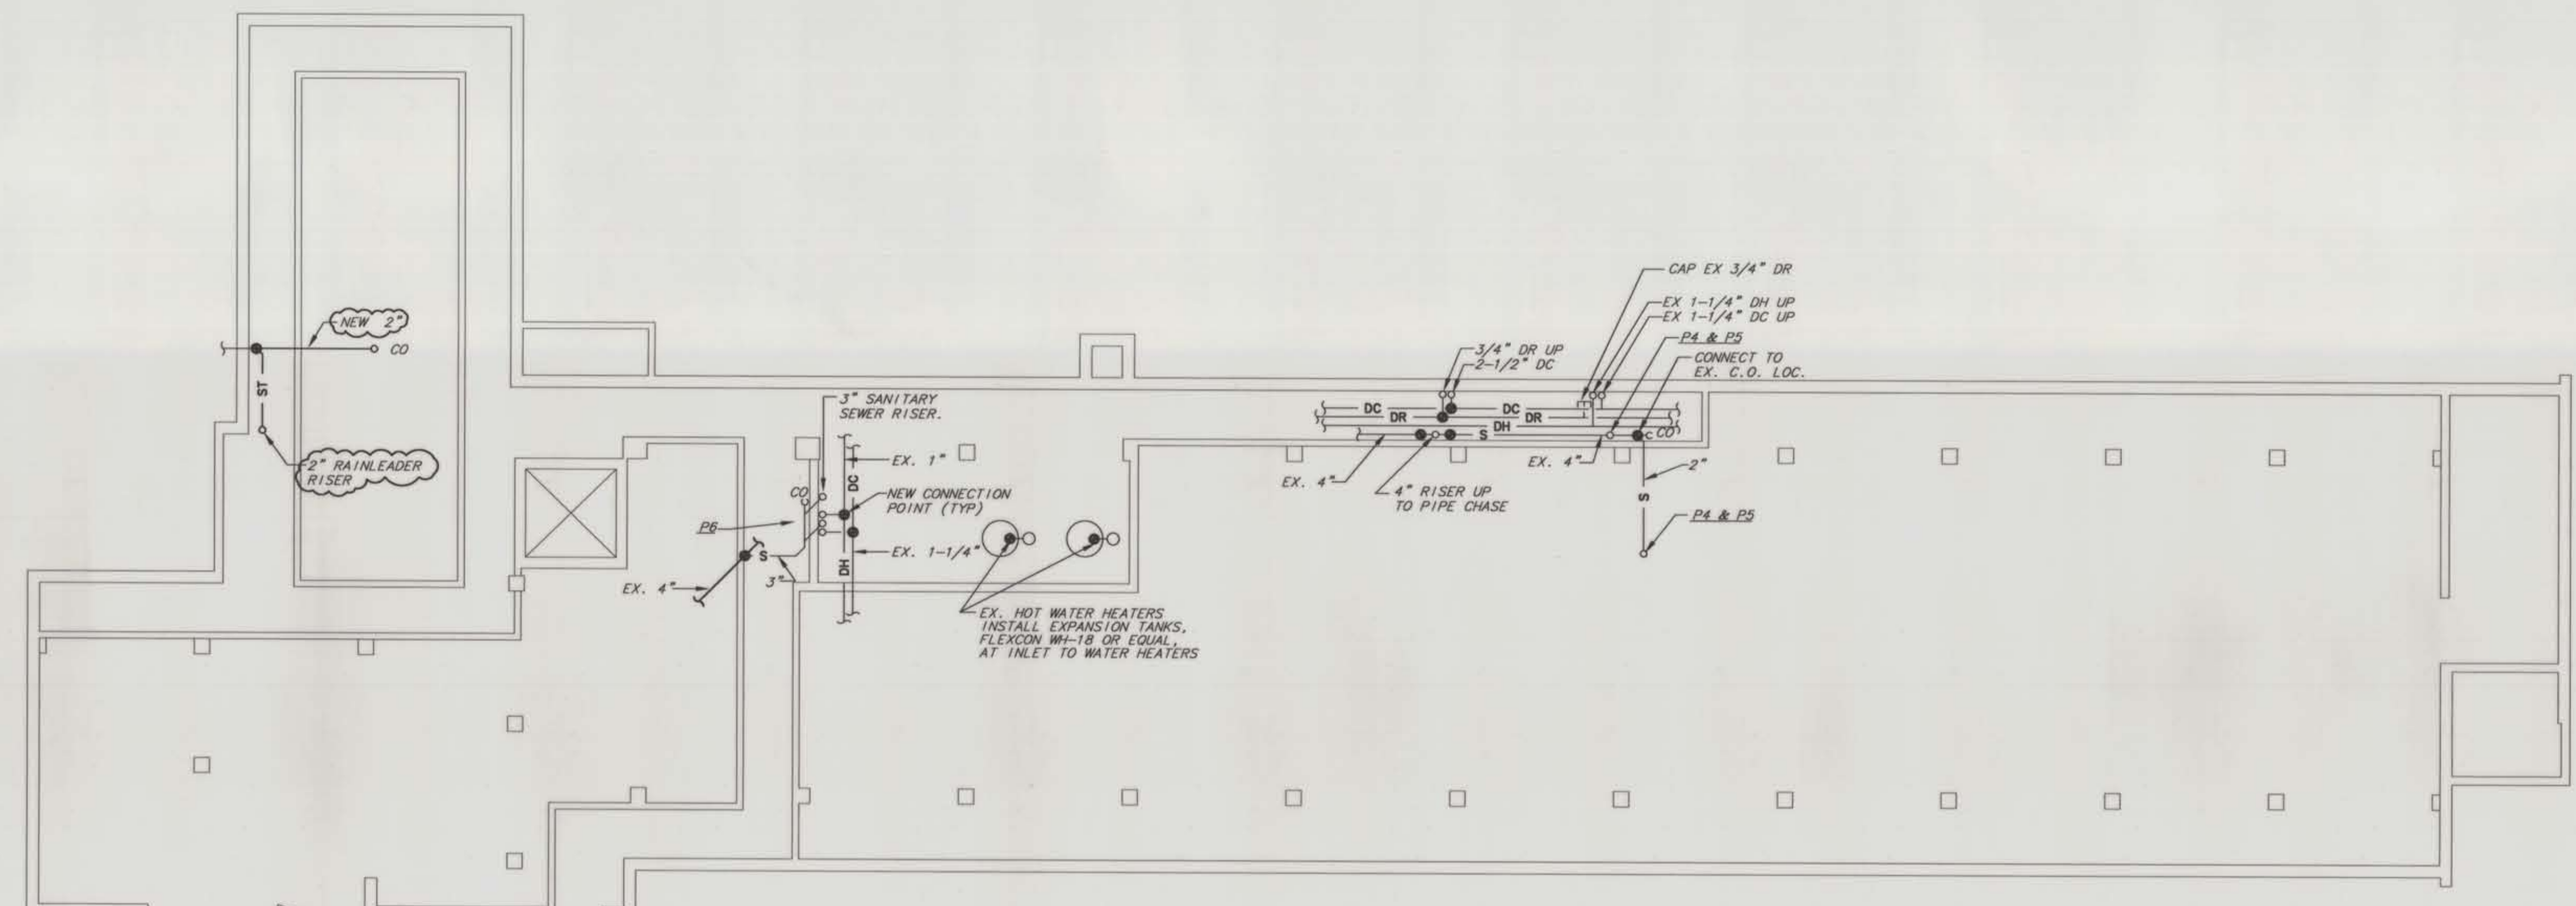

1 CRAWLSPACE PLAN
M4 FLBQ 1/8"-1'-0"

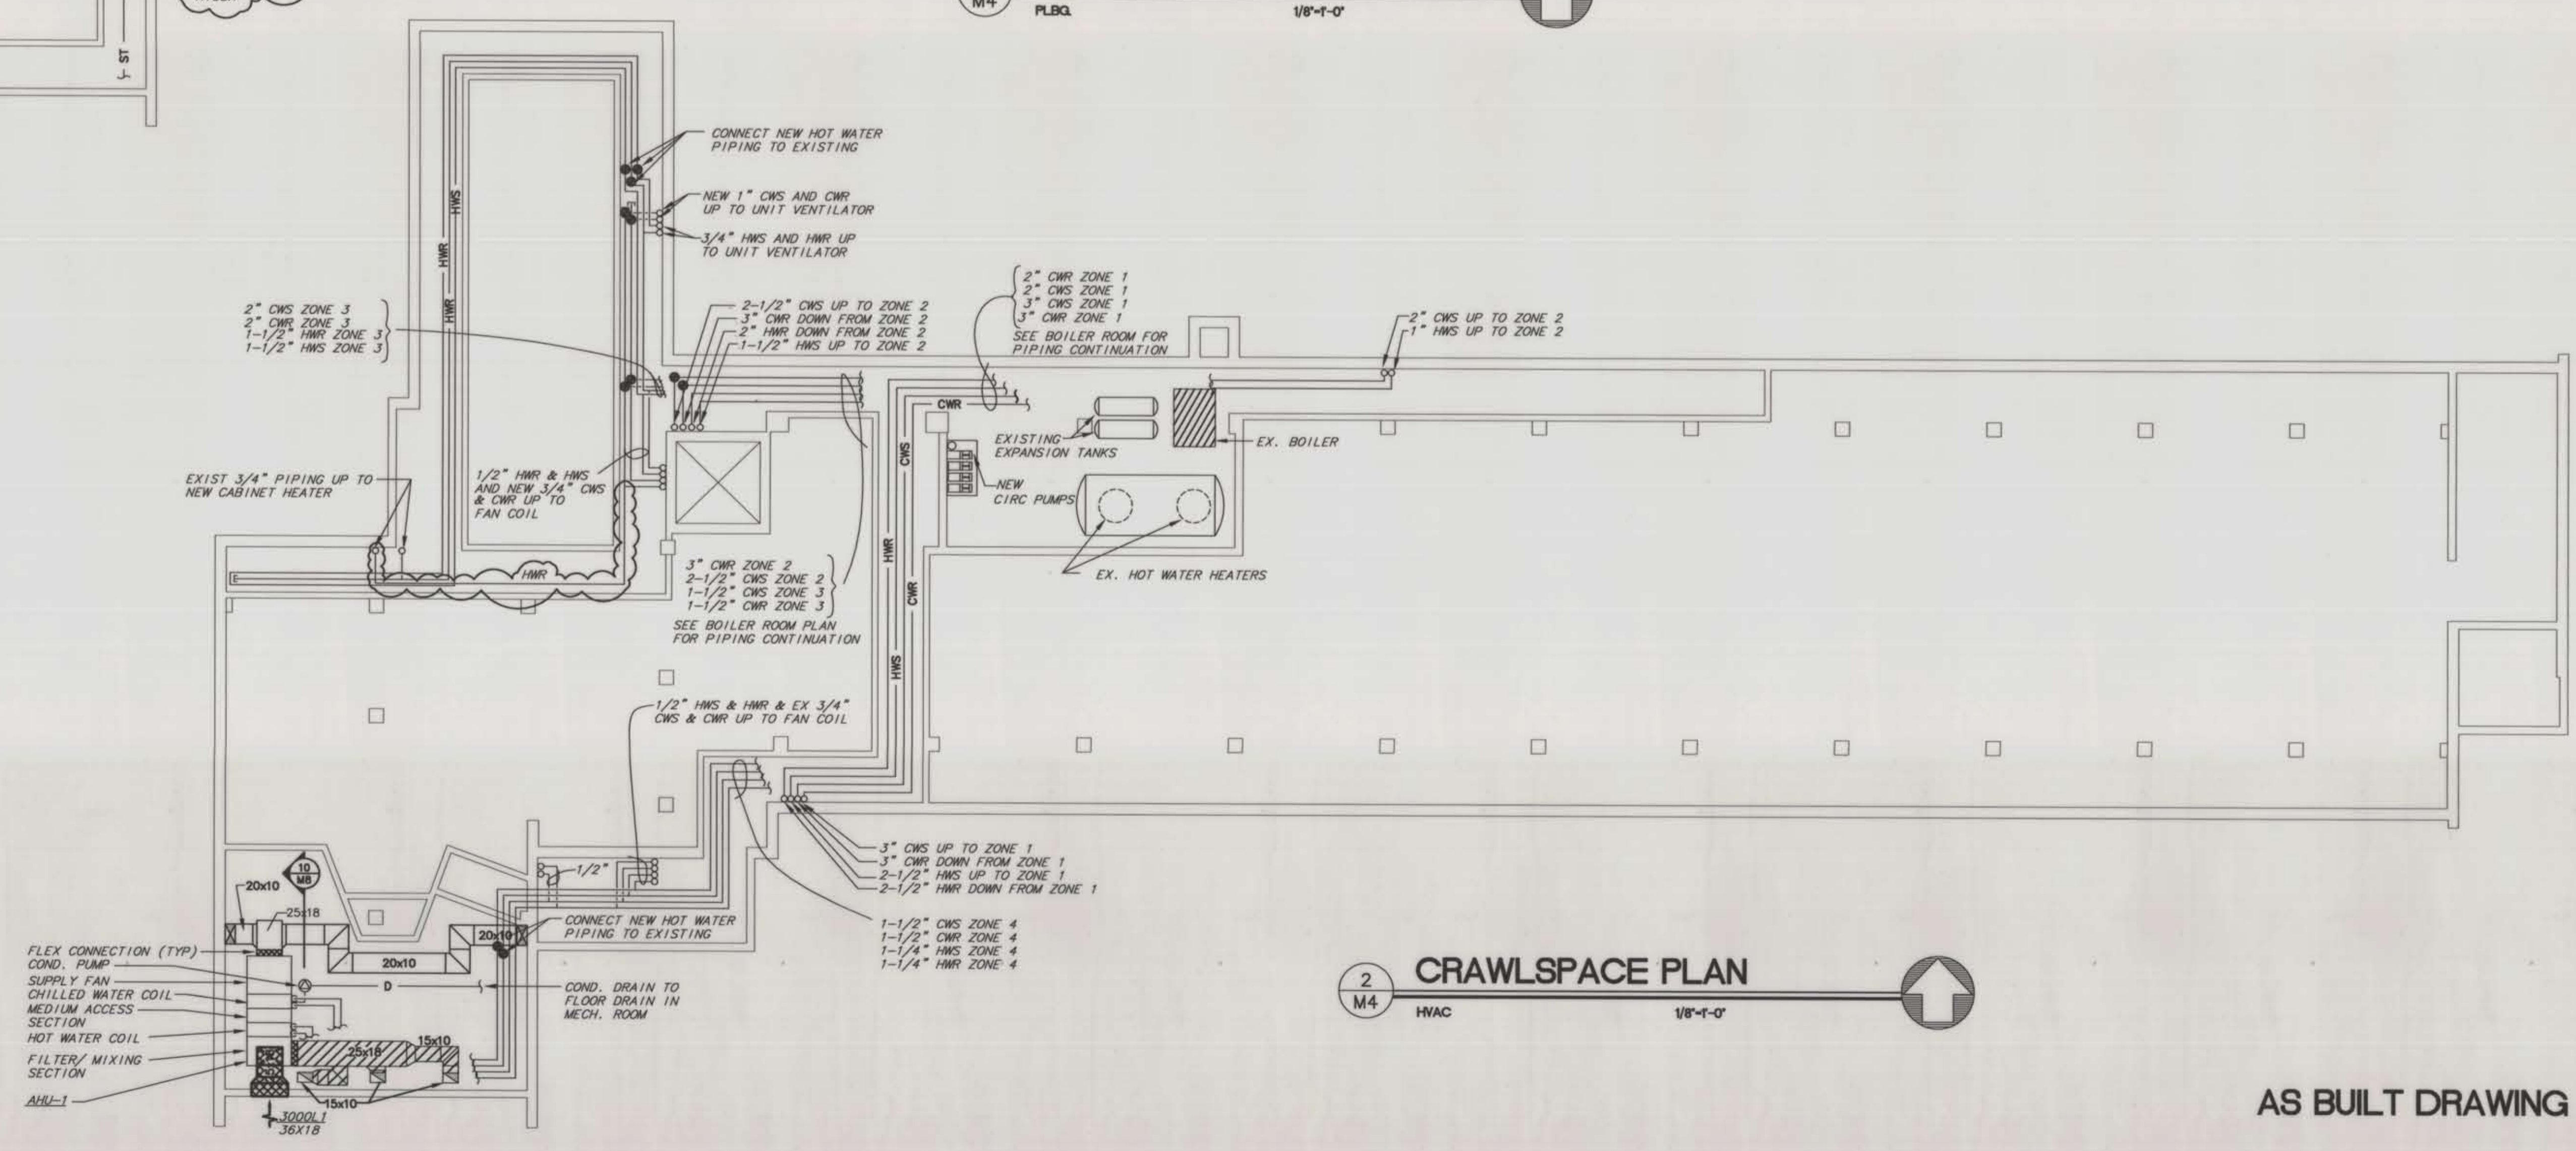

2 CRAWLSPACE PLAN
M4 HVAC 1/8"-1'-0"

AS BUILT DRAWING