


1
E5
LIGHTING
1/8"=1'-0"

PANEL C

1	LIGHTS 201 - 206 N.W.	2	LIGHTS 200
3	OUTLETS 201-203	4	BATT. PACK, EXIT, EAS & FC 200
5	LIGHTS 221 - 224 S.W.	6	LIGHTS 210 - 214 N.E.
7	LIGHTS 215 - 220 S.E.	8	LIGHTS & OUTLETS 207, 208, 209
9	OUTLETS 223, 224 STAIR FC	10	SPARE
11	PLUGMOLD 222	12	OUTLET 210
13	SPARE	14	OUTLETS 222 - 224
15	SPARE	16	OUTLETS 220 - 224
17	OUTLETS 211 - 213	18	OUTLETS 217 - 219
19	OUTLETS 213, 214 STAIR CH	20	OUTLETS 215, 216
21	SPARE	22	OUTLETS 217 - 219
23	OUTLETS 221, 222	24	OUTLETS 215 - 217
25	OUTLETS 204, 205	26	OUTLETS 219 - 221
27	OUTLLES 205, 206	28	OUTLETS 204 - 206
29	SPARE	30	OUTLETS 210 - 212
31	SPARE	32	OUTLETS 213, 214

TELEPHONE / DATA NOTES:

- 4-CAT5 / 4PR TO EACH JACK LOCATION
- TAG EACH WIRE AT EACH END WITH # SHOWN
- LEAVE 12' OF SLACK ON EACH WIRE AT JACK LOCATION
- AT BACKBOARD LOCATIONS LEAVE ENOUGH WIRE TO FROM CEILING TO FLOOR

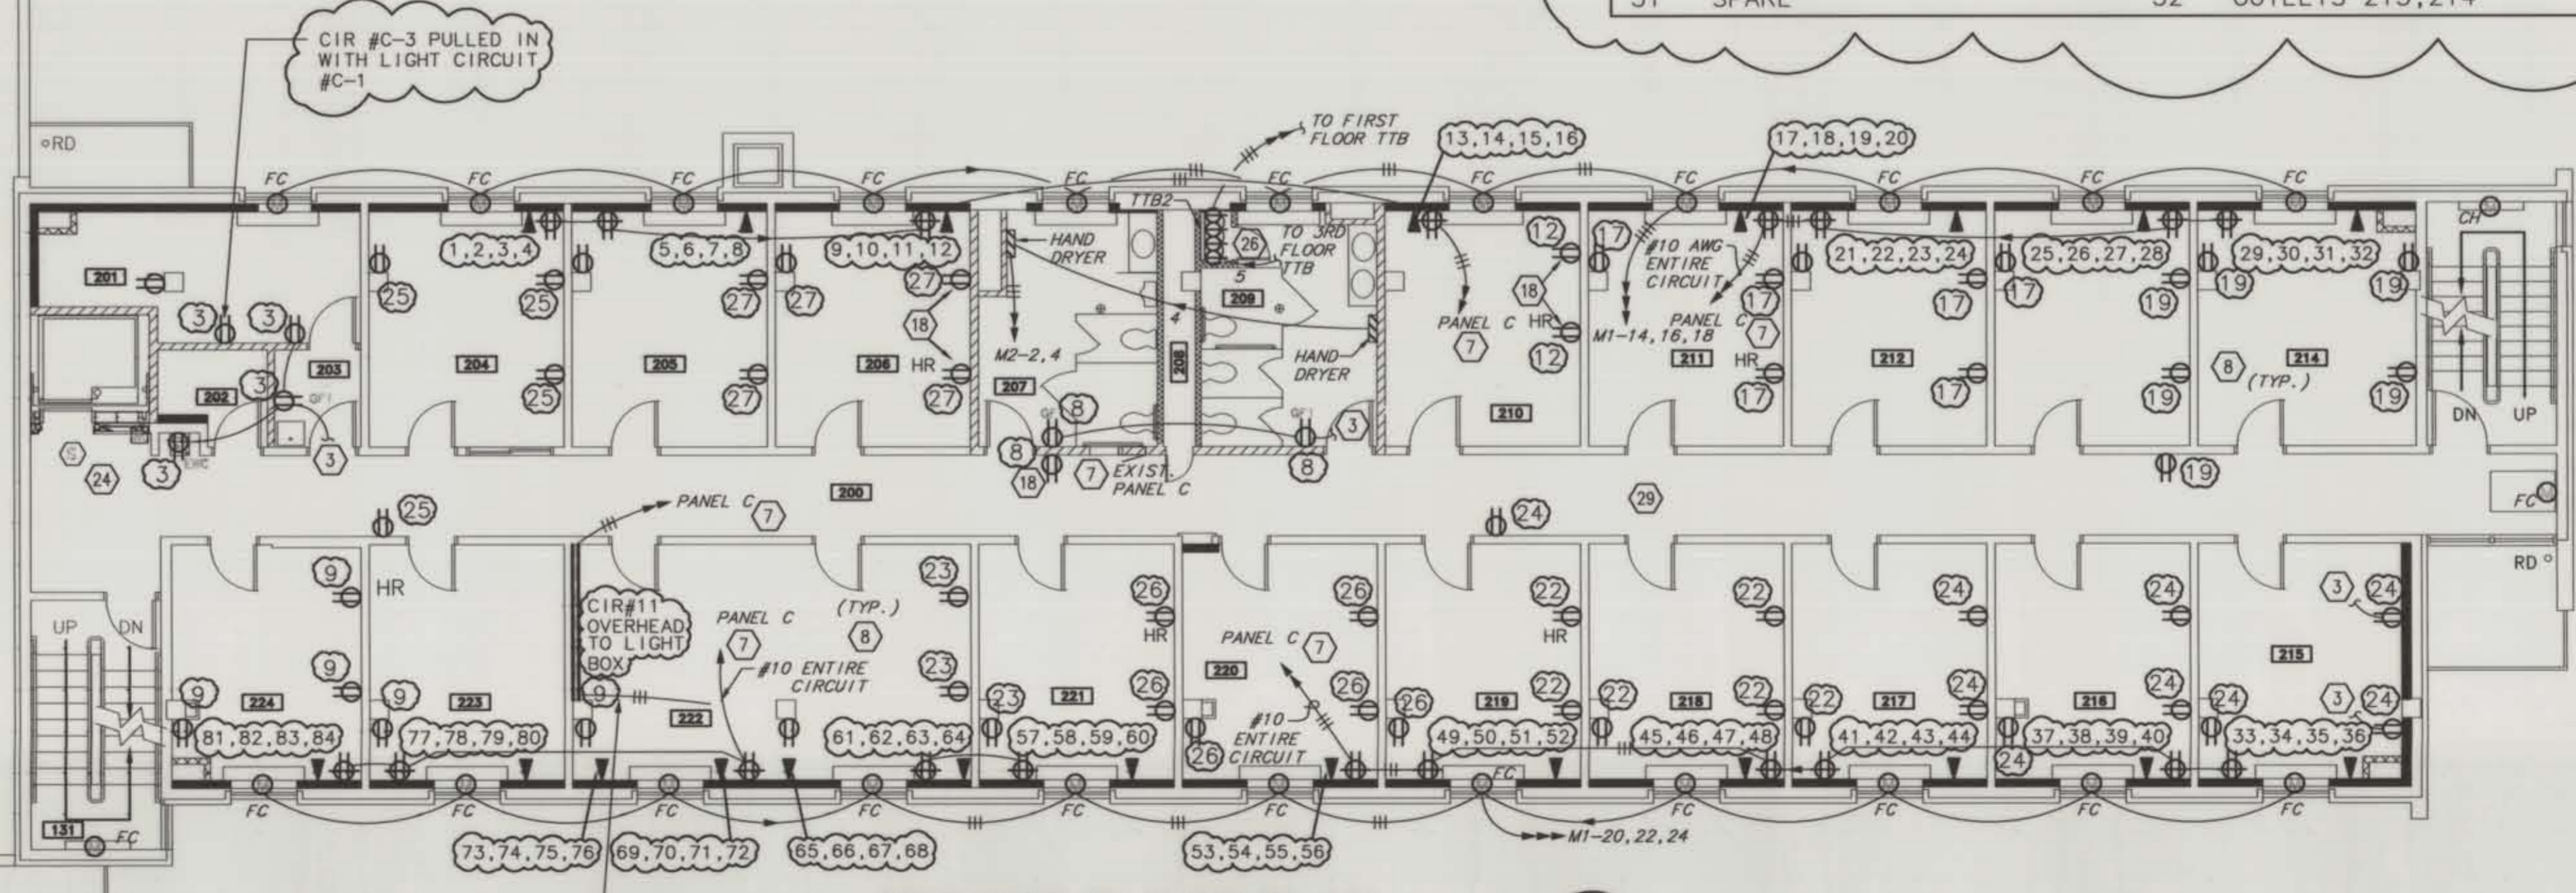

2
E5
POWER
1/8"=1'-0"

AS BUILT DRAWING