

NAME	14	M1				PANE	L SCHEDU	LE				ROOM NO.	3	
		GE AQ SURFACE	VOLT LI	MAINS : LUGS VOLT LL: 208 VOLT LN: 120 PHASE : 3							PHASE CONDUCTORS: NEUTRAL CONDUCTORS: GROUND WIRE: CONDUIT SIZE: CONDUIT RUNS: PERCENT VOLTAGE DROP:			
BRKR AMP P		DESCRIPTION	VOLT	L 0	CIR	LOAD				L 0		DESCRIPTION	BRKE	2
			AMPS	AD	NO.	A B		c	NO.	A D D E	AMPS		AMP	T
15	3	CP 1	720		1	1920		1	2		1200	FCU'S	20	Ī
			720		3		1920		4		1200	FCU'S	20	
			720		5			1720	6		1000 (NORTH WP OUTLET	20	
20	3	CP 2	1320		7	2520			8		1200	FCU'S	20	
			1320		9		2520		10		1200	FCU'S	20	
			1320		11 -			2520	12		1200	FCU'S	20	
20	3	CP 3	1320		13	2520			14		1200	FCU'S	20	
			1320		15		2520		16		1200	FCU'S	20	
			1320		17			2520	18		1200	FCU'S	20	
20	3	CP 4	1320		19	2520			20		1200	FCU'S	20	
			1320		21		2520		22		1200	FCU'S	20	
			1320		23			2520	24		1200	rcu's	20	
15	3	AHU 1	720		25	1920			26		1200	FCU'S	20	
			720		27		1920		28		1200	FCU'S	20	1
			720		29			1920	30		1200	FCU'S	20	1
20	1,	EF 4	720		31	1920		44	32		1200	FCU'S	20	1
20	1	EF 5	720		33		1920	100	34		1200	FCU'S	20	1
20	1	EF 6	720		35	16		1920	36		1200	FCU'S	20	1
20	1	EF 1	720		37	900			38		180	CRAWL SPACE RECPT.	20	1
20	1	EF 2	720		39		960	100	40		240	CRAWL SPACE LIGHT	20	1
20	1	EF 3	720		41			1220	42		500	TC PANEL	20	1
			PHASE	TOTA	NLS IVE.	14220 14280	14280 14280	14340 14280	*					
						60	0	60						

% UNBALANCE 0.42 0.00 0.42

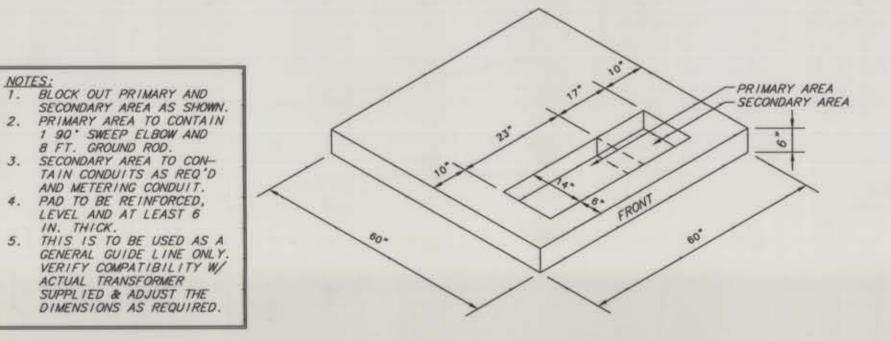

TRANSFORMER PAD DETAIL

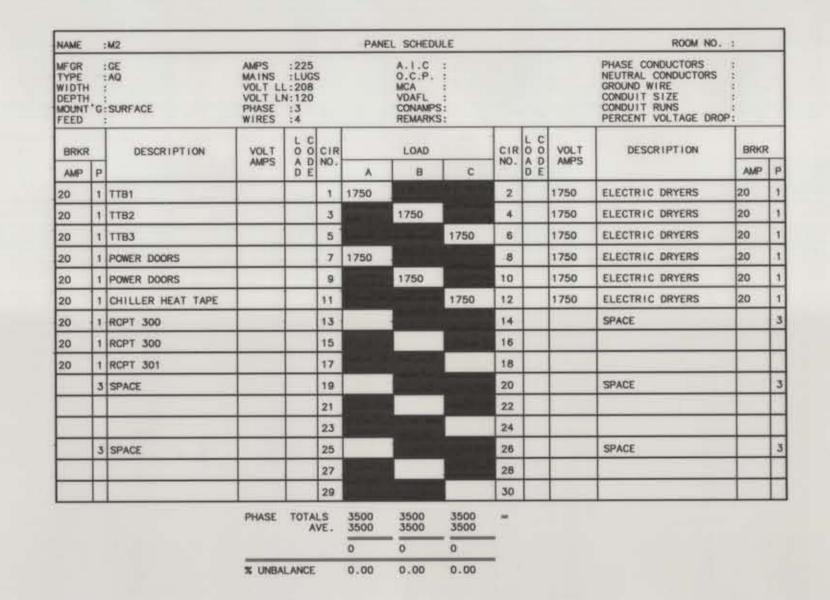

	ELECTRICAL	LEGE	NO.
-	PANEL	Œ	OUTLET, POWER
	HOME RUN TO PANEL, NO. OF ARROWS	Œ	OUTLET, DRYER
	INDICATES NO. OF CIRCUITS.	Œ	OUTLET, RANGE
-111	NO. OF HASH MARKS INDICATES NO. OF CONDUCTORS IN CONDUIT. NO HASH MARKS	=	OUTLET, DUPLEX SWITCHED
	INDICATES TWO CONDUCTORS—GROUND CONDUCTORS ARE NOT INCLUDED IN WIRE	(9)	OUTLET, MOTOR
	COUNT.	0	OUTLET, THERMOSTAT
	CONDUIT, CONCEALED IN CEILING OR WALL	(4)	OUTLET, SPECIAL PURPOSE
	CONDUIT, CONCEALED IN/OR UNDER FLOOR	0	OUTLET, FLOOR, POWER
	CONDUIT EXPOSED	0	OUTLET, FLOOR, TELEPHONE
	PLUGMOLD	S	OUTLET, SPEAKER
-	FLEX CONDUIT	0	OUTLET, JUNCTION BOX
223	SPECIAL CABINETS	0	OUTLET, T.V.
\boxtimes	MOTOR STARTER	-14	OUTLET, MICROPHONE
i⊠h,	COMB. MOTOR STARTER-DISCONNECT	0	PHOTO CELL
	LIGHT FIXTURE, FLUORESCENT	(6)	OCCUPANCY SENSOR
•	LIGHT FIXTURE, H.I.D.	HĐ	PRIVACY CALL SWITCH
0	LIGHT FIXTURE, INCANDESCENT	HO	CLOCK
	LIGHT FIXTURE, STRIP	MIC	AREA OF RESCUE MASTER INTERCOM STAT
\otimes	EXIT SIGN	[IC]	AREA OF RESCUE INTERCOM STATION
<i></i>	LIGHT FIXTURE EQUIPPED W/ EMERGENCY	10	TIME CLOCK
- 99	BATTERY PACK	0	PUSH BUTTON
	LIGHT FIXTURES, WALL MOUNTED	B	BUZZER
\$	SWITCH		DRY TYPE TRANSFORMER
\$2	SWITCH, DOUBLE POLE	Bo	BELL
\$3	SWITCH, 3-WAY	田	FIRE ALARM BREAKGLASS STATION
\$4	SWITCH, 4-WAY		FIRE ALARM VISUAL SIGNAL
\$ DR	SWITCH, DOOR	Eba	FIRE ALARM AUDIO/VISUAL SIGNAL
\$к	SWITCH, KEY OPERATED		FIRE ALARM AUDIO SIGNAL
\$и	SWITCH, MOTOR STARTER	(S)	SMOKE DETECTOR
\$p	SWITCH, WITH PILOT LIGHT	(9)	HEAT DETECTOR
\$p	SWITCH, DIMMER	<u>S</u> —	- DUCT DETECTOR
\$LV	SWITCH, LOW VOLTAGE		MAGNETIC DOOR HOLDER
\$т	SWITCH, TIMER	-	OUTLET, COMBINATION TELEPHONE/DATA
0-	OUTLET, SIMPLEX	EM	EMERGENCY
0	OUTLET, DUPLEX	EX	EXPLOSION PROOF
0	OUTLET, COMBINATION	WP	WEATHERPROOF
Φ=	OUTLET, DOUBLE DUPLEX	GFI	GROUND FAULT INTERRUPTER
0=	OUTLET, ON EM POWER		

HEX NOTES:

(1) CONNECT NEW FIXTURES TO EXISTING SWITCHED LIGHTING CIRCUIT IN ROOM.

(2) EXISTING PANEL B. THERE ARE 3 EXISTING 20A/1P SPARES. REMOVE 1-20A/2P AND 1-30A/2P BREAKERS WHICH FED REMOVED LOADS. INSTALL 4-20A/1P BREAKERS IN SPACES VACATED. 7-20A/1P BREAKERS WILL BE AVAILABLE.

(3) EXTEND TO EXISTING CIRCUIT. VERIFY ADEQUATE AMPACITY.

(4) EXISTING PANEL A. THERE ARE 7 EXISTING 20A/1P SPARES. CONNECT NEW CIRCUITS AS REQUIRED.

5 EXISTING PANEL P. REMOVE 50A/3P SPARE AND 15A/1P SPARE. INSTALL 4-20A/1P BREAKERS.

(6) EXISTING 3RD FLOOR PANEL D HAS 7-20A/1P SPACES. ALSO ADD 20A/1P IN EXISTING SPACE. REMOVE 30A/2P AND INSTALL 2-20A/1P SPARES. 10-20A/1P BREAKERS EXIST FOR USE.

(7) EXISTING 2ND FLOOR PANEL C HAS 6-20A/1P SPARES. INSTALL 20A/1P BREAKER IN EXISTING SPACE. REMOVE 30A/2P BREAKER AND REPLACE W/2-20A/1P BREAKERS.

(8) CIRCUITING IN REMODELED SPACES. DEVICES SHOWN IN WALLS WHICH ARE FURRED OUT ARE TO BE RECESSED. CONCEAL CIRCUITS WHEREVER POSSIBLE IN NEW FURRED WALLS, ACCESSIBLE CEILINGS, ETC. WIRING OR DEVICES ON EXISTING MASONRY WALLS TO BE IN METALLIC SURFACE RACEWAY AND BOXES, UNLESS SPECIFICALLY NOTED OTHERWISE. COORDINATE RACEWAY ROUTING WITH EXISTING CONCRETE BEAMS. COORDINATE SURFACE RACEWAY ROUTING WITH ARCHITECT AND ENGINEER.

9 ROUTE TO EXISTING 20A/1P CIRCUIT WHICH FED REMOVED LIGHTING IN THIS AREA. VERIFY CAPACITY PRIOR TO CONNECTION.

CONNECT MOTION SENSOR AND POWER PACK PER MANUFACTURER'S RECOMMENDATIONS.

SEE SPECIFICATION. CONNECT MOTION SENSOR UP STREAM FROM SWITCHES TO DISABLE ENTIRE CIRCUIT IF ROOM IS UNOCCUPIED.

CONNECT TO EXISTING ROOM LIGHTING CIRCUIT. REPLACE SWITCHES WITH NEW 3-WAY OR 4-WAY SWITCHES AS INDICATED. CONNECT AS REQUIRED. EXISTING CONDUIT MAY BE REUSED WHEREVER POSSIBLE.

(12) CONNECT AS REQUIRED TO EXISTING SWITCHED CIRCUIT.

9-20A/1P BREAKERS ARE AVAILABLE FOR USE.

(13) CONNECT TO EXISTING SWITCHED CIRCUIT IN LOCATION OF REMOVED FIXTURE.

STAIR TOWER. CONNECT NEW FIXTURE TO EXISTING CEILING BOX IN LOCATION OF REMOVED FIXTURE. SWITCHING TO REMAIN IDENTICAL TO EXISTING. INTERCEPT EXISTING CIRCUIT ON FIRST FLOOR LEVEL AND PULL ADDITIONAL HOT (UNSWITCHED) CONDUCTOR THROUGH EXISTING CONDUIT TO PROVIDE HOT, NEUTRAL, AND SWITCHED CONDUCTORS TO BATTERY BALLASTS. CONTRACTOR OPTION TO PULL IN ONE ADDI-TIONAL CONDUCTOR OR PULL OUT EXISTING AND REPLACE (WITH ADDITIONAL HOT).

(15) NOT USED.

(16) VERIFY ELEVATOR EQUIPMENT LOCATIONS WITH SUPPLIER.

(17) CIRCUIT CORRIDOR LIGHTING IN WIREMOLD OVER BEAMS. WRAP BEAM AND PAINT TO MATCH BEAM.

(18) INSTALL NEW DEVICE - CONNECT TO EXISTING CIRCUIT.

19 TV OUTLET TO BE 4"X4" BOX WITH BANK COVER PLATE AT +72". STUB 3/4" CONDUIT TO TUNNEL BELOW.

(20) CORRIDOR LIGHTING CIRCUITS. ALL CONDUCTORS (PHASE, NEUTRAL, SWITCH LEGS)
TO BE #10 AWG. CONDUIT TO BE 3/4". (WIREMOLD TO HAVE EQUIVALENT CAPACITY

(21) EXISTING RECESSED PANELS IN MASONRY WALLS. NEW CIRCUITS OUT OF THESE EXISTING PANELS TO BE CONCEALED. CUT AND PATCH EXISTING WALLS AS REQUIRED

TO CONCEAL CIRCUITS.

(22) ROUTE 2" E.C. INTO ELECTRICAL ROOM FOR FUTURE USE.

FLOOR BOX. STEEL CITY 642 TWO GANG. INSTALL DUPLEX RECEPTACLE AND RESERVE SPACE FOR FUTURE DATA OUTLET. INCLUDE POLISHED BRASS COVER PLATE (DUPLEX LIFT LIDS AND 1" N.P.S. PLUG).

PROVIDE TWO CONTACT TYPE SMOKE DETECTORS. SIMPLEX 2098 SERIES PHOTOELECTRIC TYPE. PROVIDE MAGNETIC DOOR HOLDERS - SIMPLEX SERIES 2088-WALL MOUNTED. ROUTE SMOKE DETECTOR CIRCUITING TO ELEVATOR CONTROL PANEL FOR USE BY ELEVATOR CONTRACTOR (ELEVATOR CAPTURE, RECALL, AND FIRE SERVICE). USE SECOND SMOKE DETECTOR CONTACT TO CONTROL MAGNETICALLY HELD DOOR. PROVIDE POWER SUPPLIES AND OTHER DEVICES AS REQUIRED. PROVIDE ALL CIRCUITING AS REQUIRED. ALL CIRCUITING IN CONDUIT. CONNECT AND CIRCUIT DEVICES AS REQUIRED TO PROVIDE A COMPLETE AND FULLY FUNCTIONING SYSTEM.

25) ELBOWS IN 2" TELEPHONE CONDUIT RUNS TO BE GENTLE SWEEPS TO FACILITATE FUTURE FIBER OPTIC CABLE INSTALLATION.

(26) INSTALL SIMPLEX AND/OR DUPLEX OUTLETS FOR TTB'S AT +72" - AT TOP OF TTB.

(PER UMC). CIRCUIT AS REQUIRED FOR SHUTDOWN OF EQUIPMENT AS REQUIRED BY UMC. COORDINATE WITH TEMP CONTROL AND MECHANICAL CONTRACTORS FOR REQUIREMENTS. DUCT DETECTOR TO BE SIMPLEX 2098 SERIES. INCLUDE DETECTOR HEAD, HOUSING, SAMPLING TUBE, REMOTE TEST STATION, AUXILIARY RELAYS, AND ALL OTHER REQUIRED COMPONENTS. CIRCUIT, POWER, AND CONNECT AS REQUIRED FOR PROPER OPERATION.

28 PROVIDE HEAT TAPE FOR CHILLER PIPING. PIPE IS 3" METAL. PROVIDE HEAT TAPE FOR ENTIRE LENGTH OF PIPING OUTDOORS (VERIFY LENGTH WITH MECHANICAL CONTRACTOR). HEAT TAPE TO BE RAY CHEM TYPE BXL1 (120V). 8W/FT, SELF REGULATING. PROVIDE POWER CONNECTION KIT AND OTHER ACCESSORIES AS REQUIRED. PROVIDE AMBIENT SENSING THERMOSTAT (SET AT 40° F) TO DIRECTLY CONTROL HEAT TAPE.

ALL CIRCUITING AND CONDUIT RUNS ARE TO BE CONCEALED UNLESS SPECIFICALLY NOTED OTHERWISE.

9504 DRAWN BY BCR CHECKED ____SAR

12-1-95

A

Z

0

B

___ 8

0

9504E8

REVISED 12-5-96

AS BUILT DRAWINGS

IN. THICK.