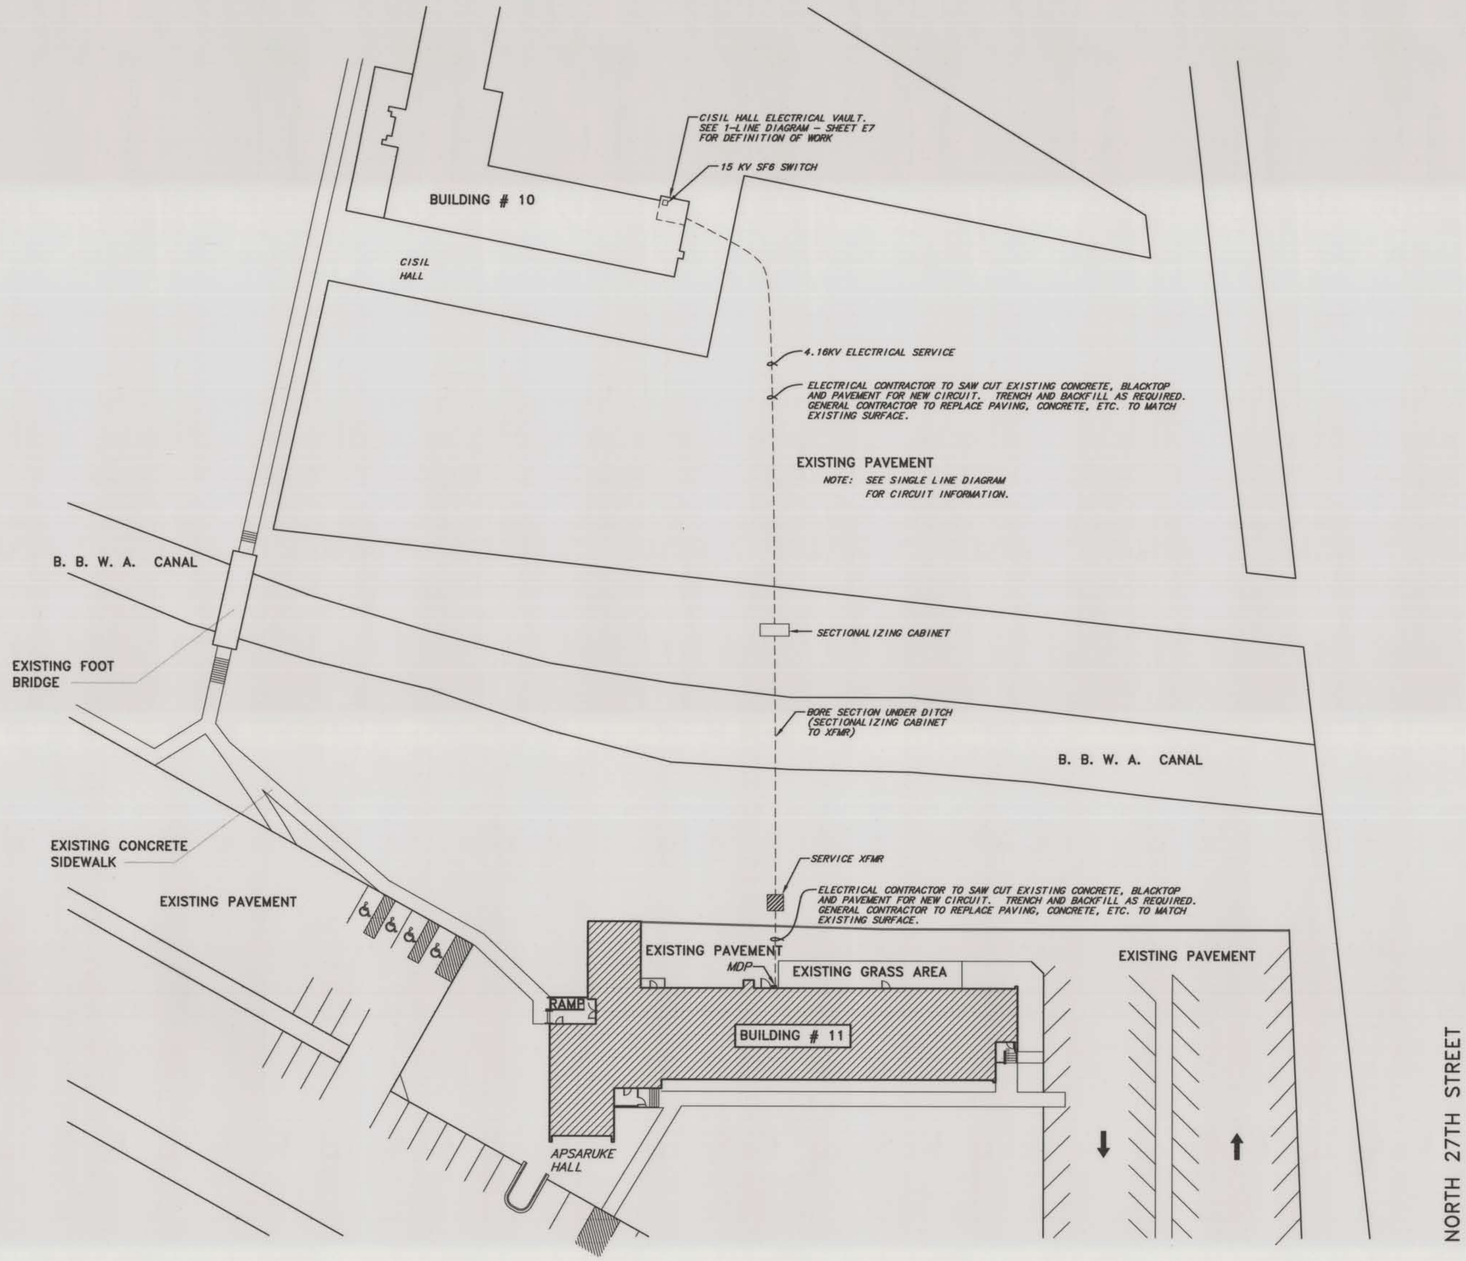

1 / E1 SITE PLAN

1" = 30'-0"

AS BUILT DRAWING

JGA ARCHITECTS ENGINEERS PLANNERS
644 Grand Avenue
Billings, Montana 59101
406-245-6383

APSARUKE HALL
MSU-BILLINGS
BILLINGS, MONTANA

JOB NO. 9504
DRAWN BY BCR/TK
CHECKED SAR
DATE 12-1-95
REVISED 12-4-96

9504E1

E1

C:\jga\CAD\9504\MECH\9504e1 Tue Dec 17 17:19:32 1996 JGA ARCHITECTS BILLINGS, MT